

SUITE: 1400

RSF: 16,248



OCEAN  
PLAZA

AS-BUILT CONFIGURATION

OFFICES.....	26
CONFERENCE ROOMS.....	5
OPEN WORK AREA.....	+/- 48
KITCHEN.....	1

*Not to scale, furniture and appliances not included*

KEY PLAN

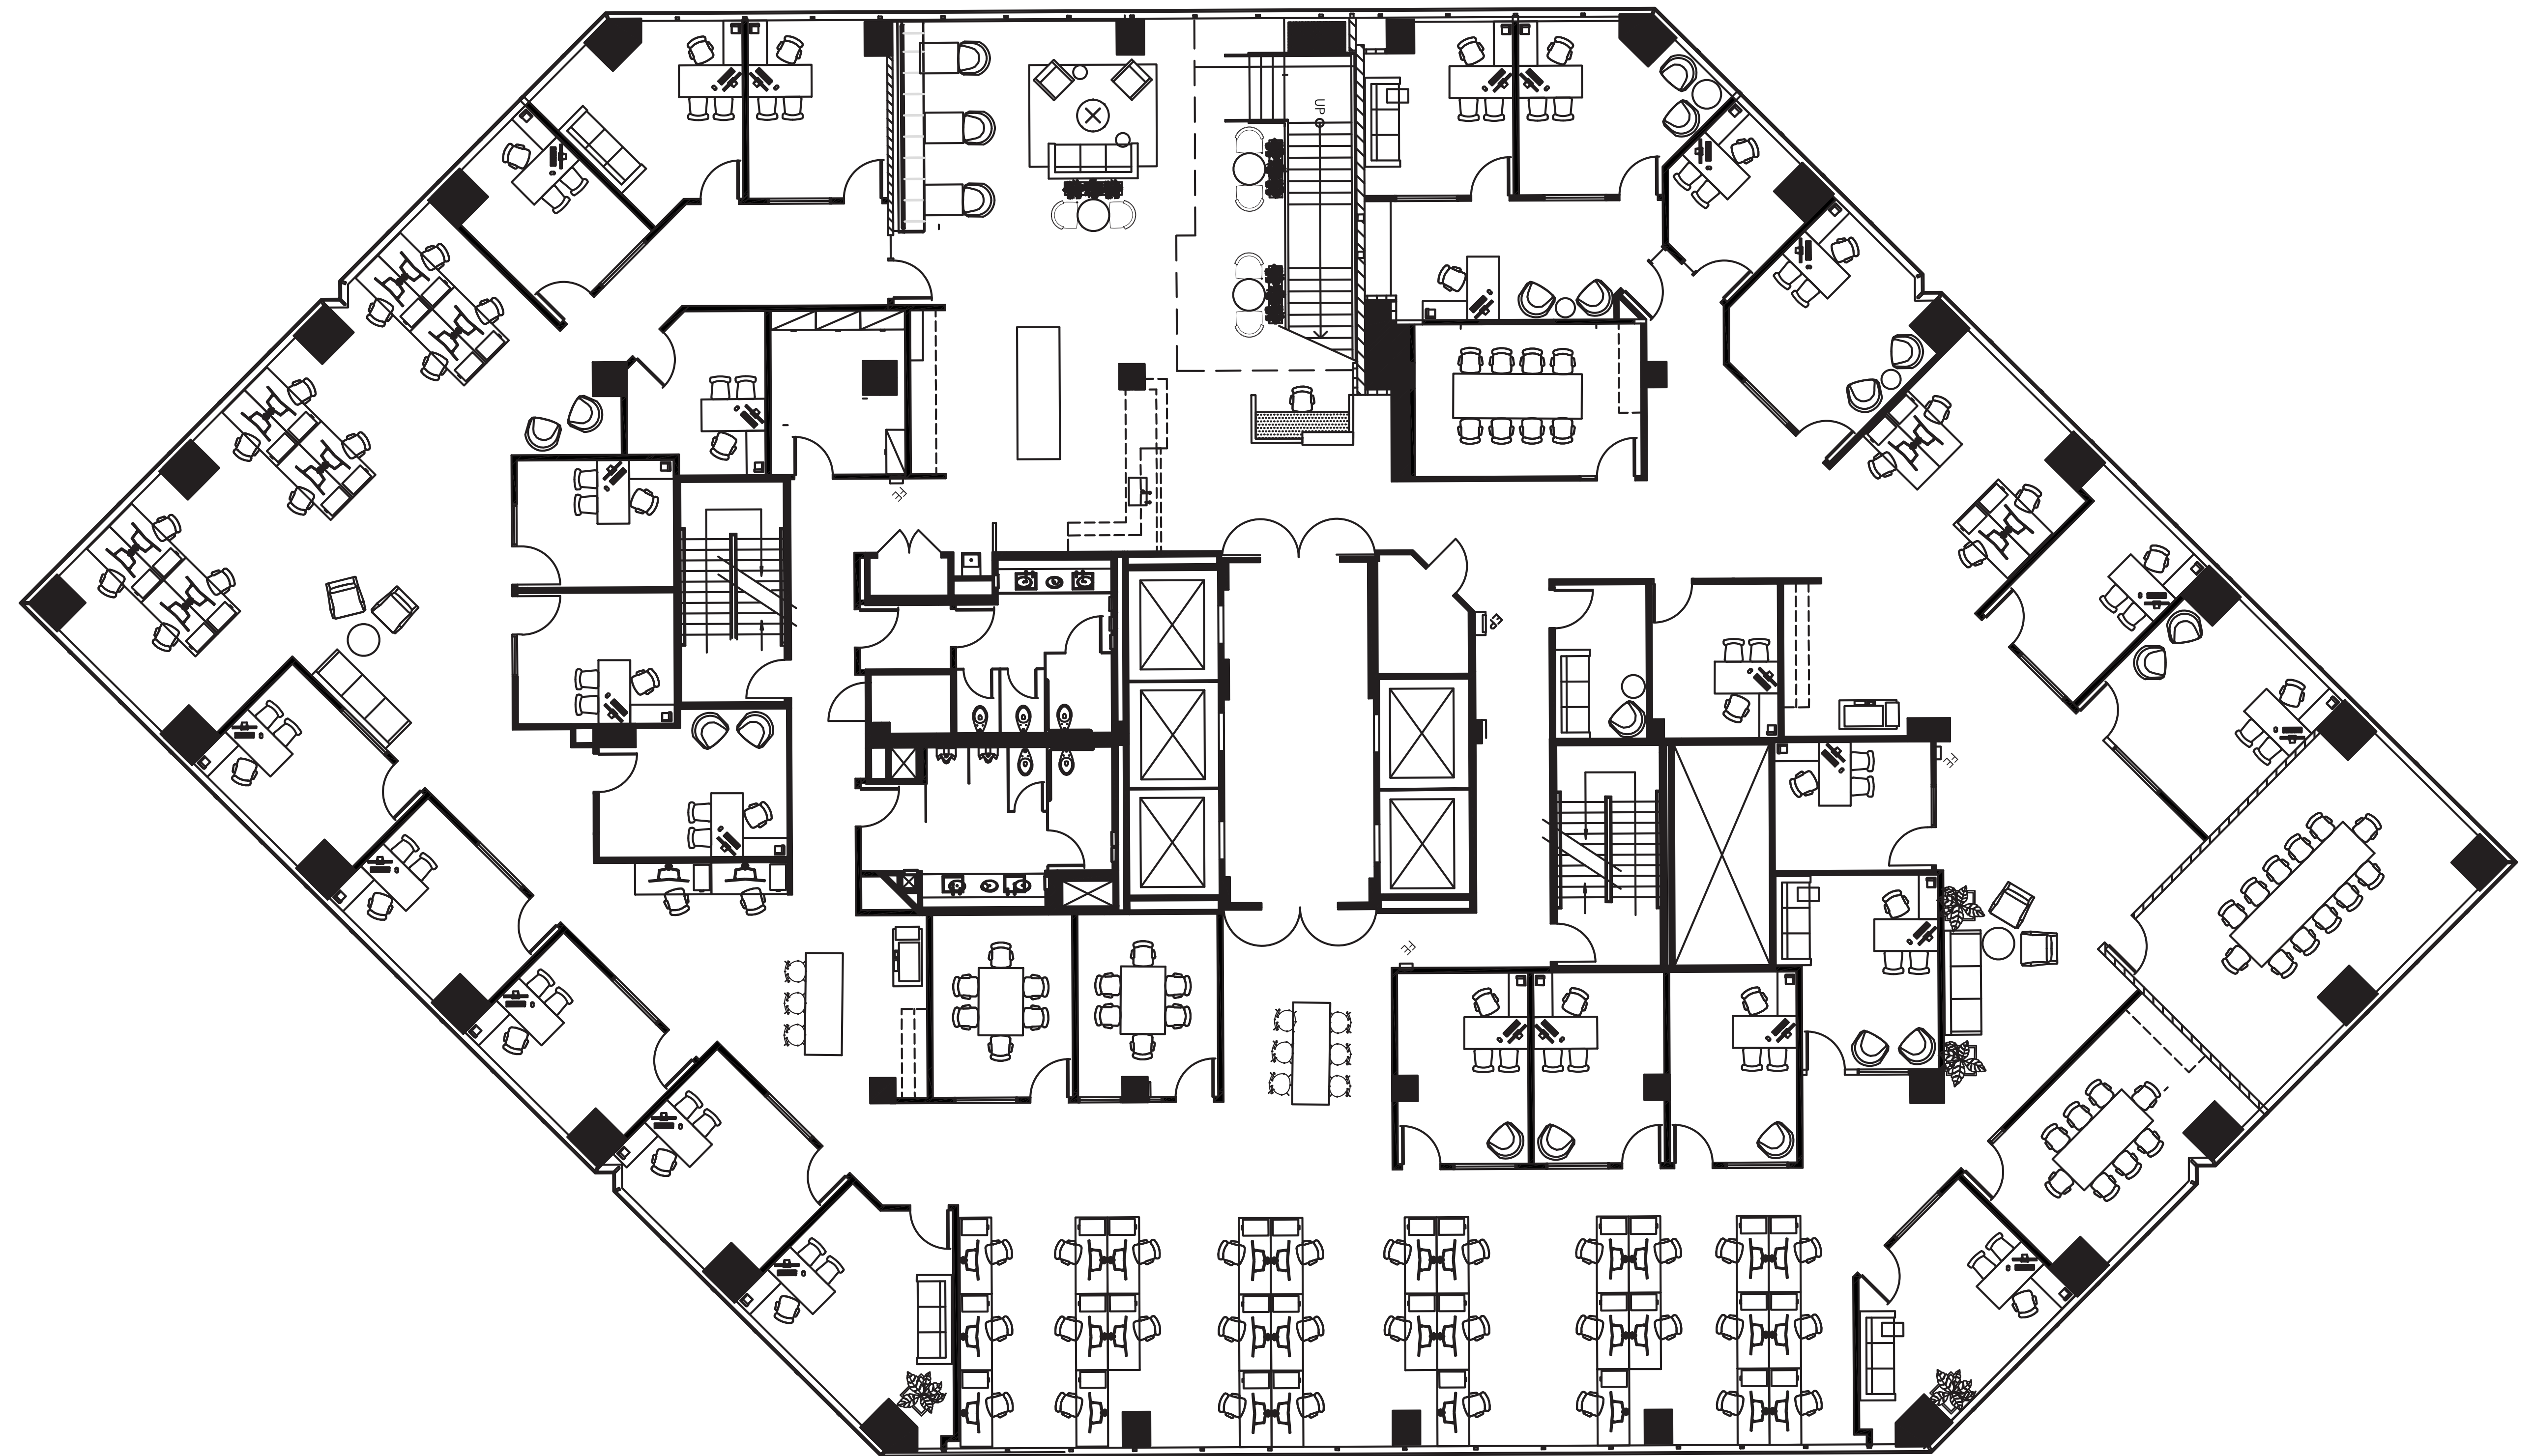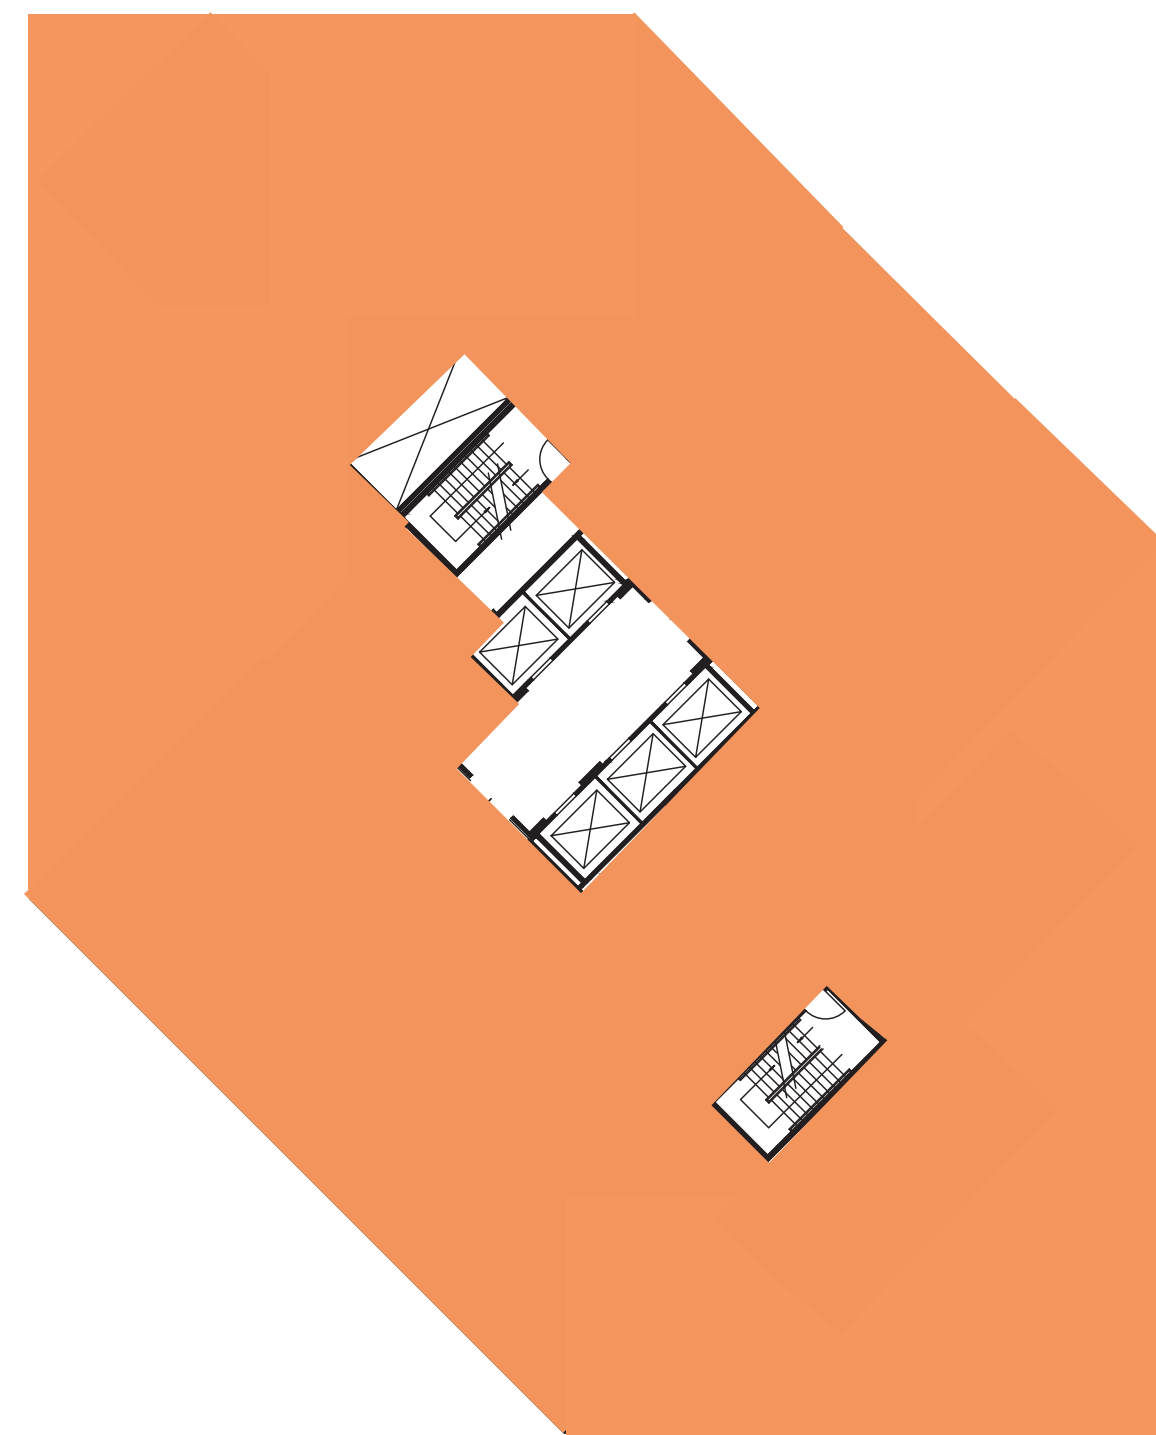

PLEASE CONTACT:  
USALEASING@ONNI.COM  
(213) 629 - 2041

onni<sup>®</sup>  
group