

SUITE: 1500

RSF: 16,368



OCEAN
PLAZA

AS-BUILT CONFIGURATION

OFFICES.....	17
CONFERENCE ROOMS.....	5
OPEN WORK AREA.....	+/- 50
KITCHEN.....	1

Not to scale, furniture and appliances not included

KEY PLAN

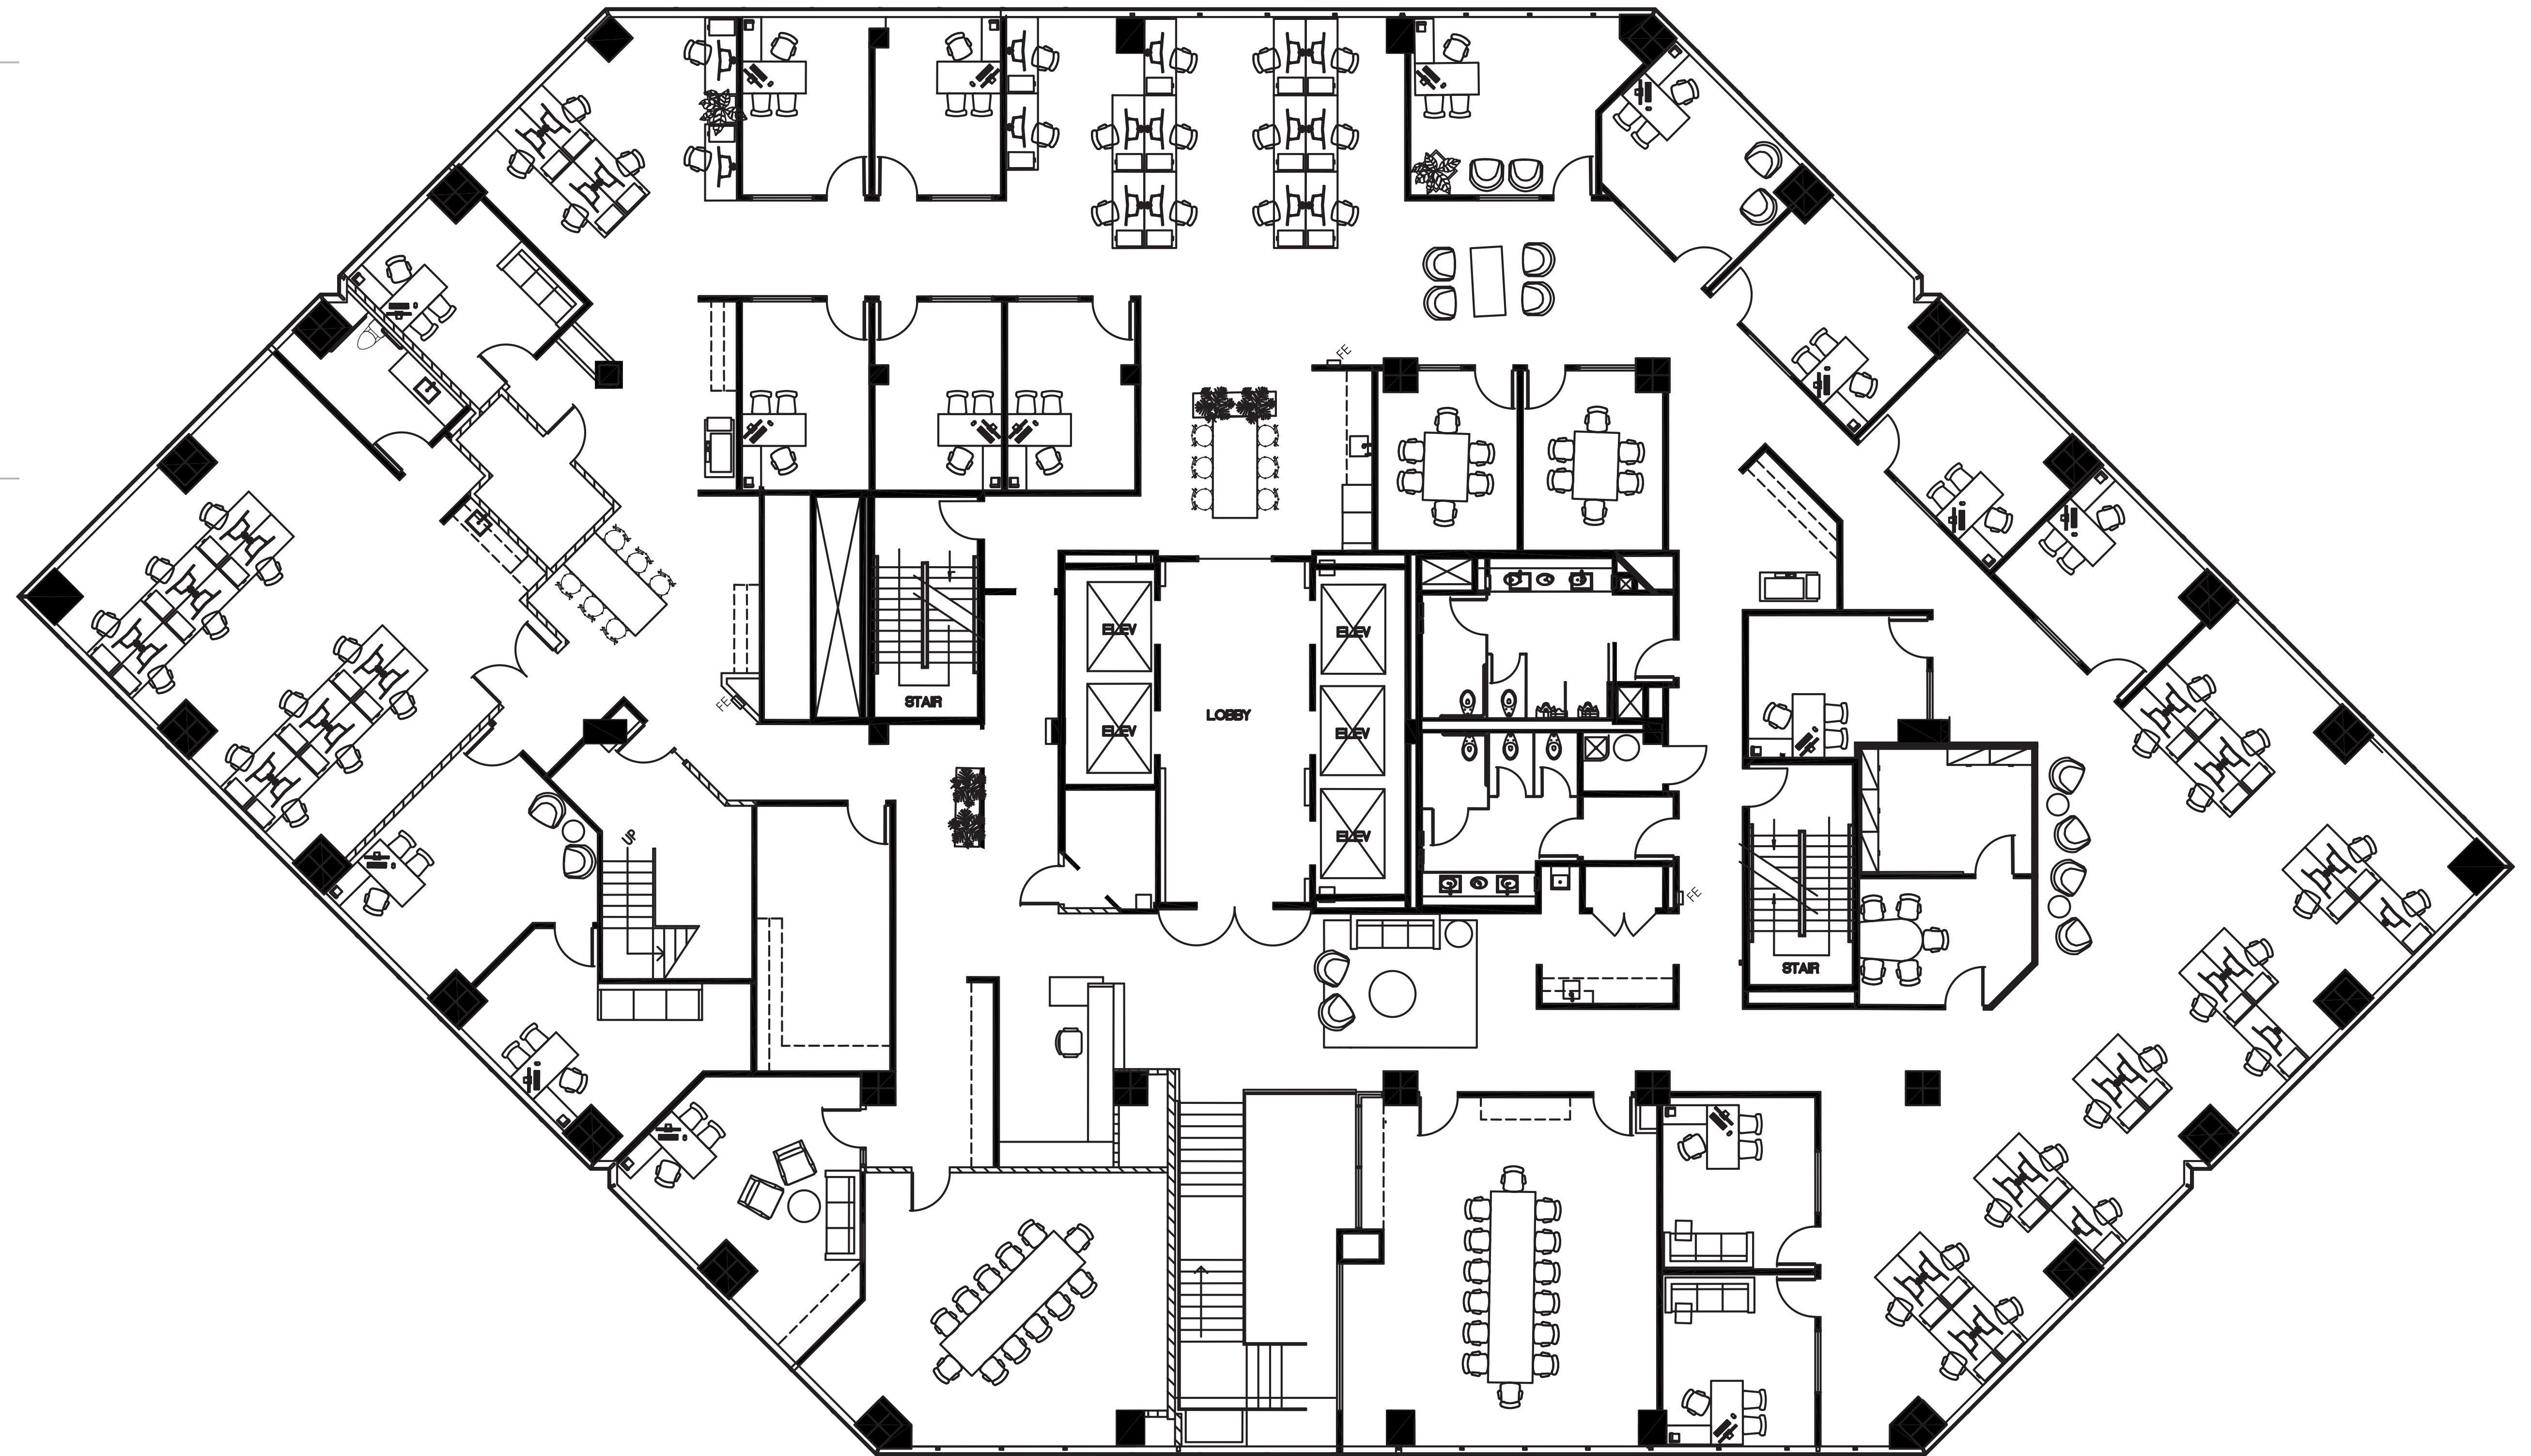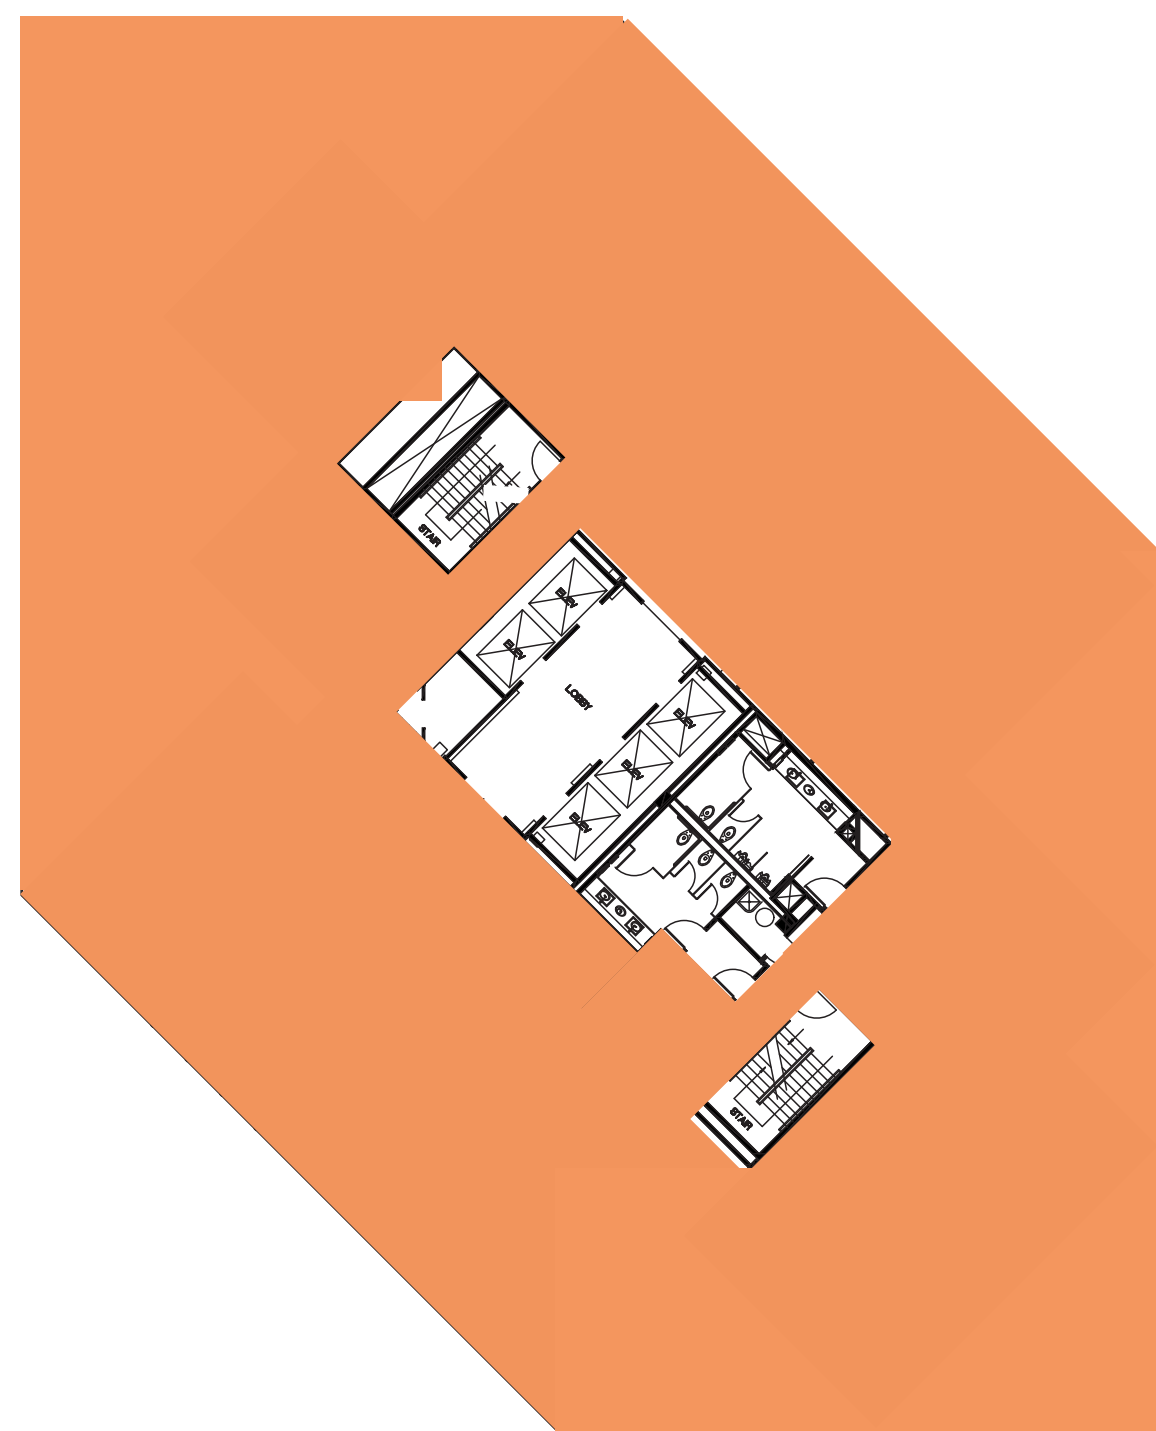

PLEASE CONTACT:
USALEASING@ONNI.COM
(213) 629 - 2041

onni[®]
group