

SUITE: 320

RSF: 6,906


OCEAN
PLAZA

AS-BUILT CONFIGURATION

OFFICES.....	5
RECEPTION.....	1
CONFERENCE ROOMS.....	2
KITCHEN.....	1
OPEN WORK AREA.....	+/-18

Not to scale, furniture and appliances not included

KEY PLAN

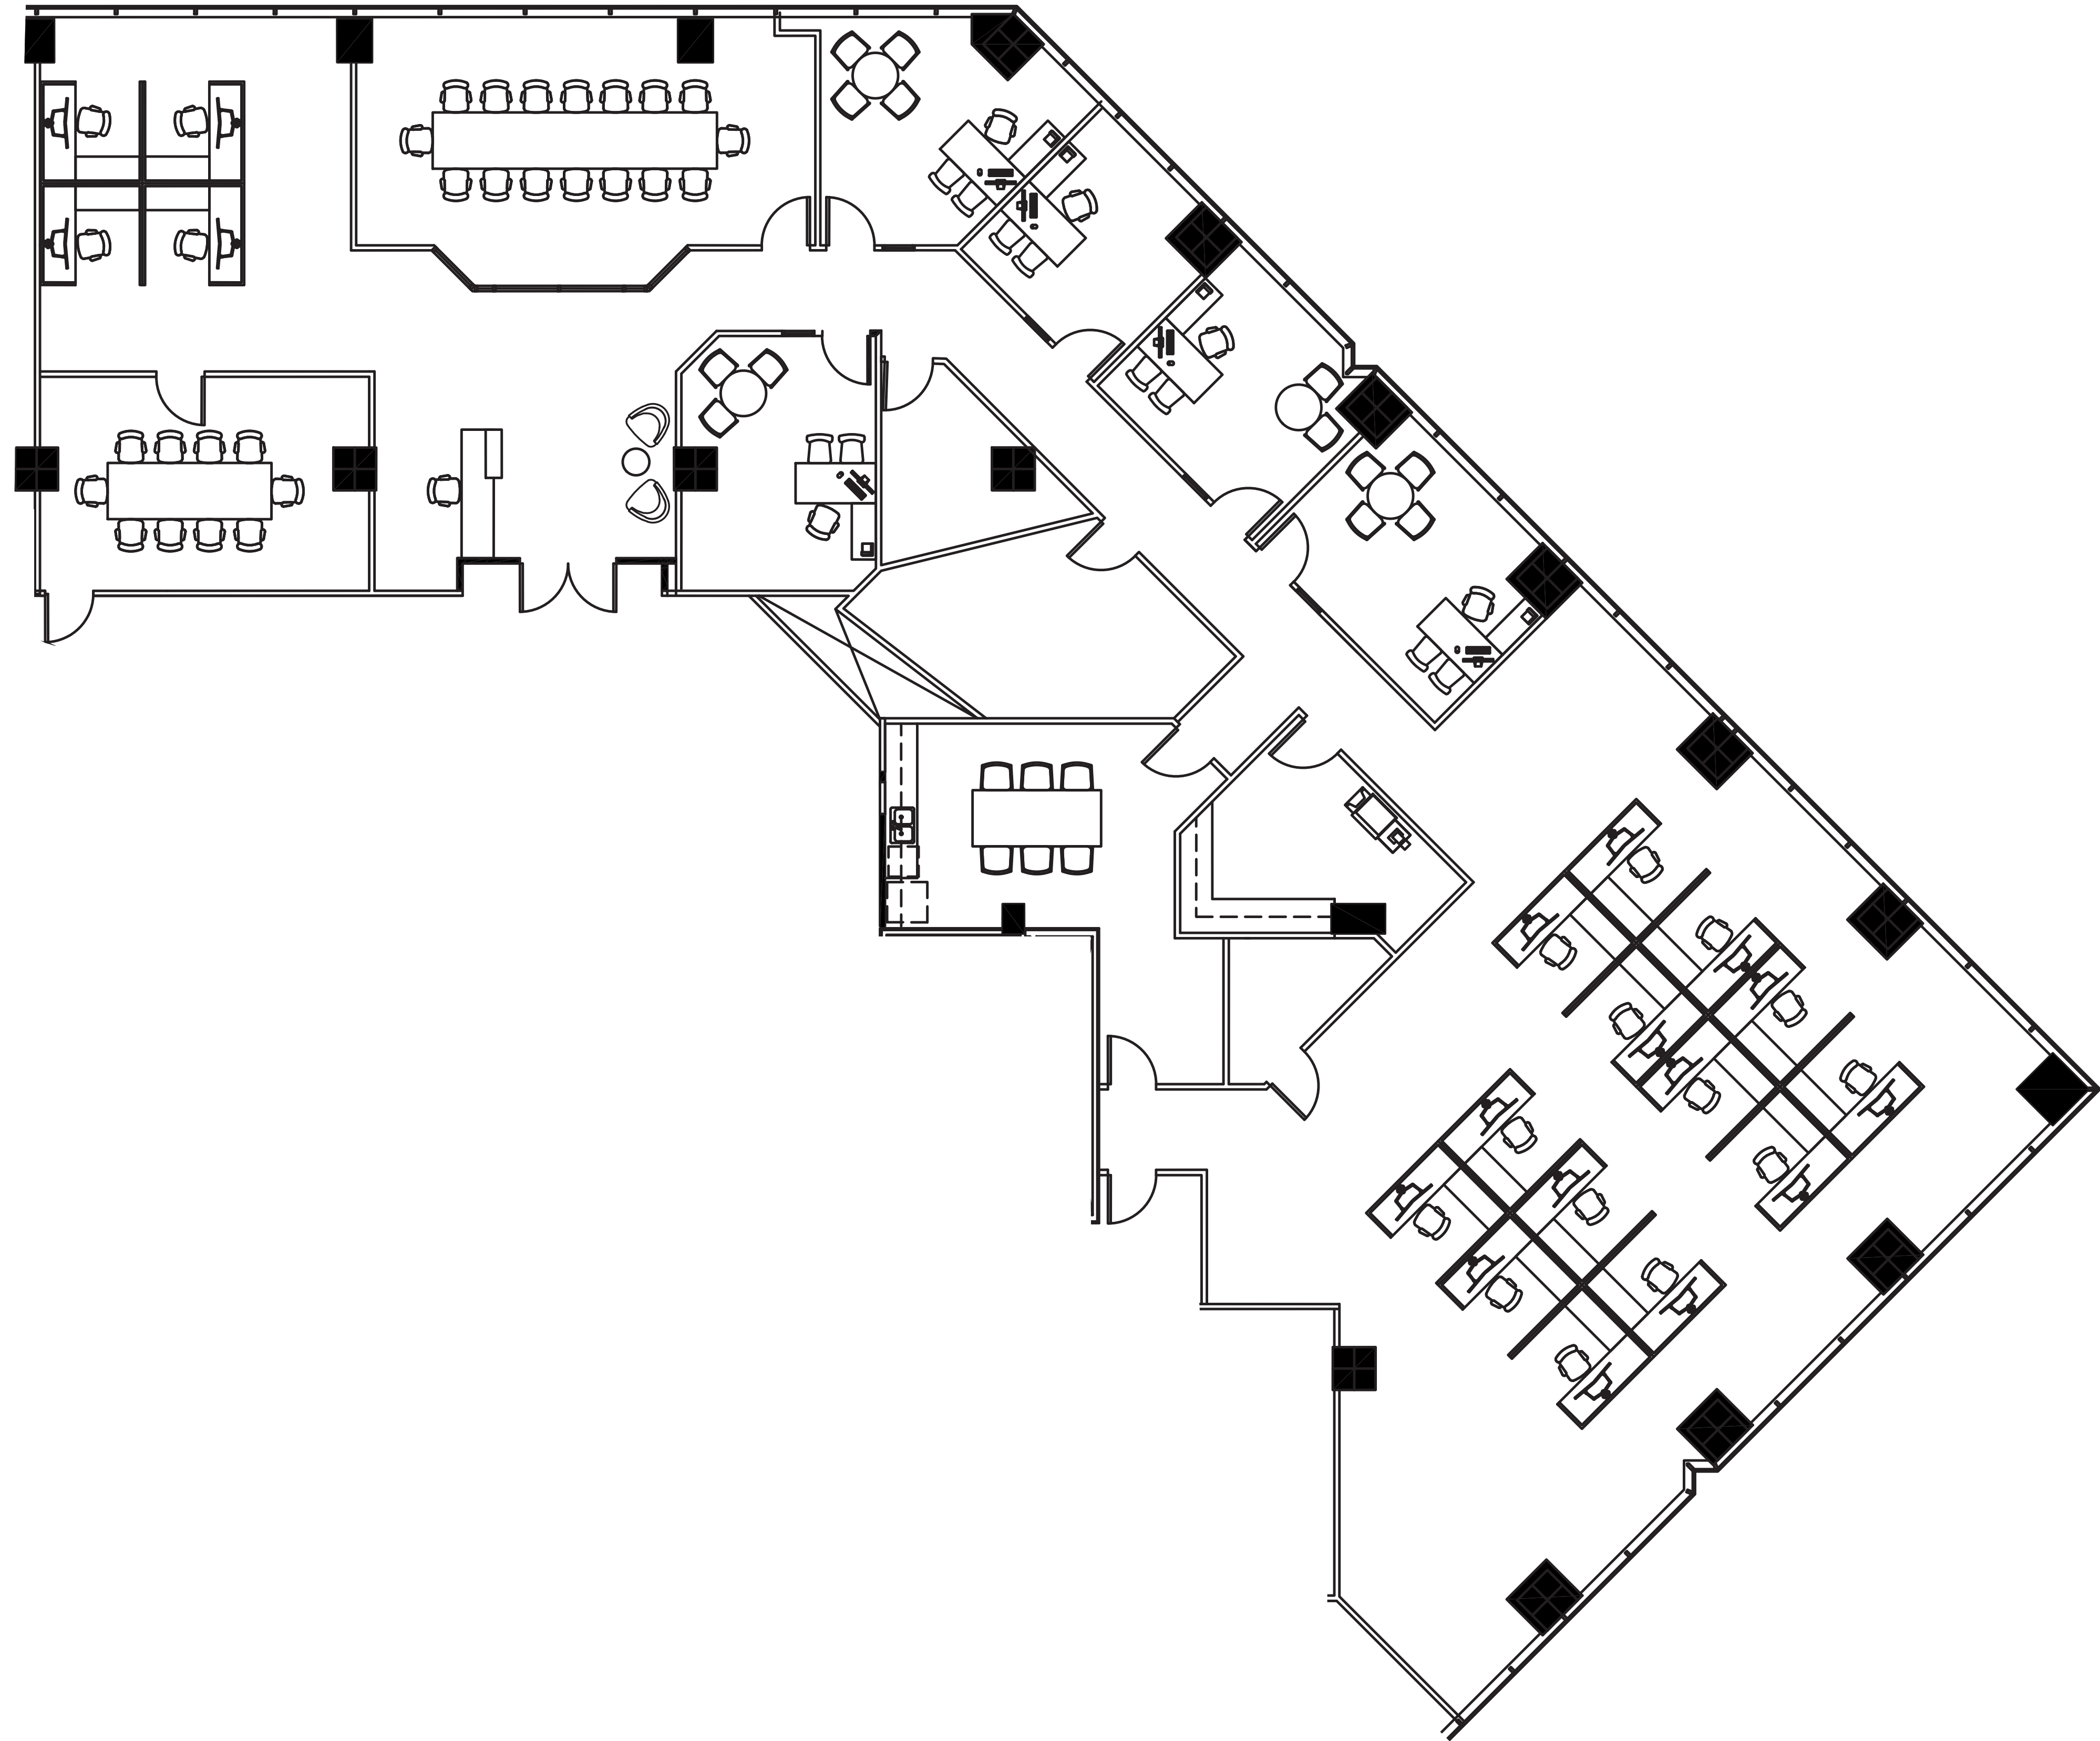

PLEASE CONTACT:
USALEASING@ONNI.COM
(213) 629 - 2041