

SUITE: 350

RSF: 4,542



OCEAN
PLAZA

AS-BUILT CONFIGURATION

OFFICES.....	N/A
RECEPTION.....	N/A
CONFERENCE ROOMS.....	N/A
KITCHEN.....	N/A
OPEN WORK AREA.....	N/A

Not to scale, furniture and appliances not included

KEY PLAN

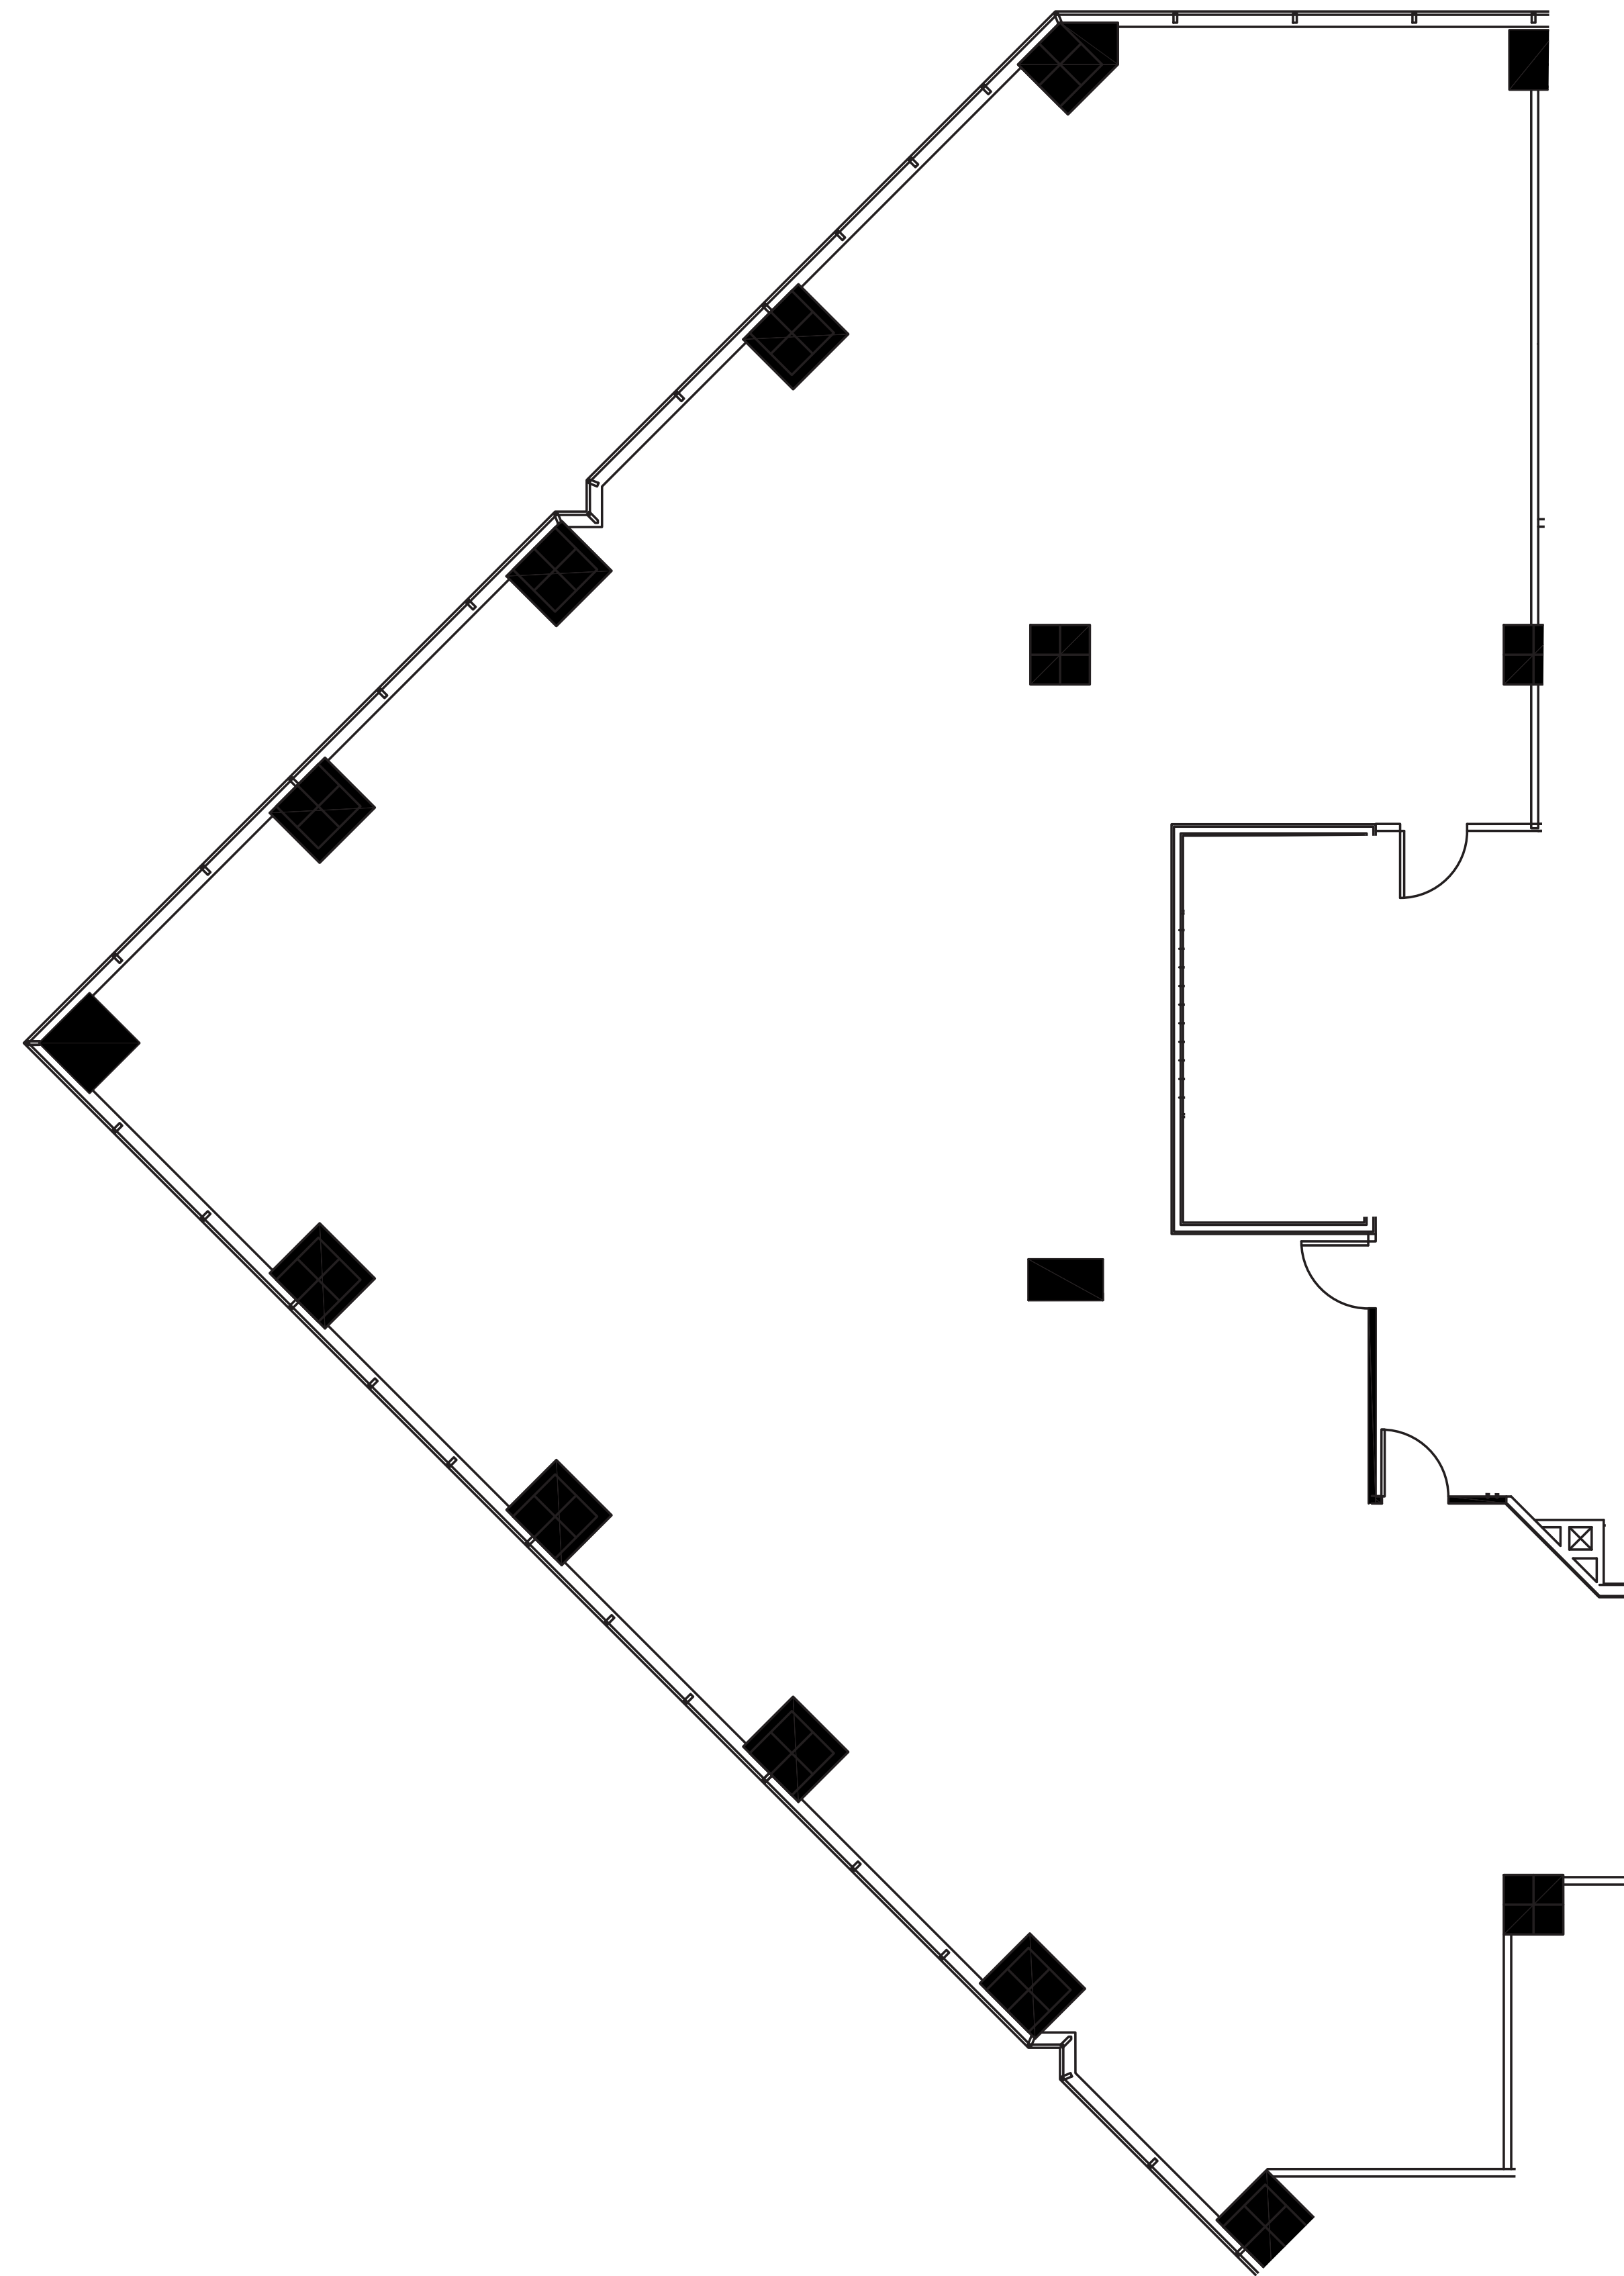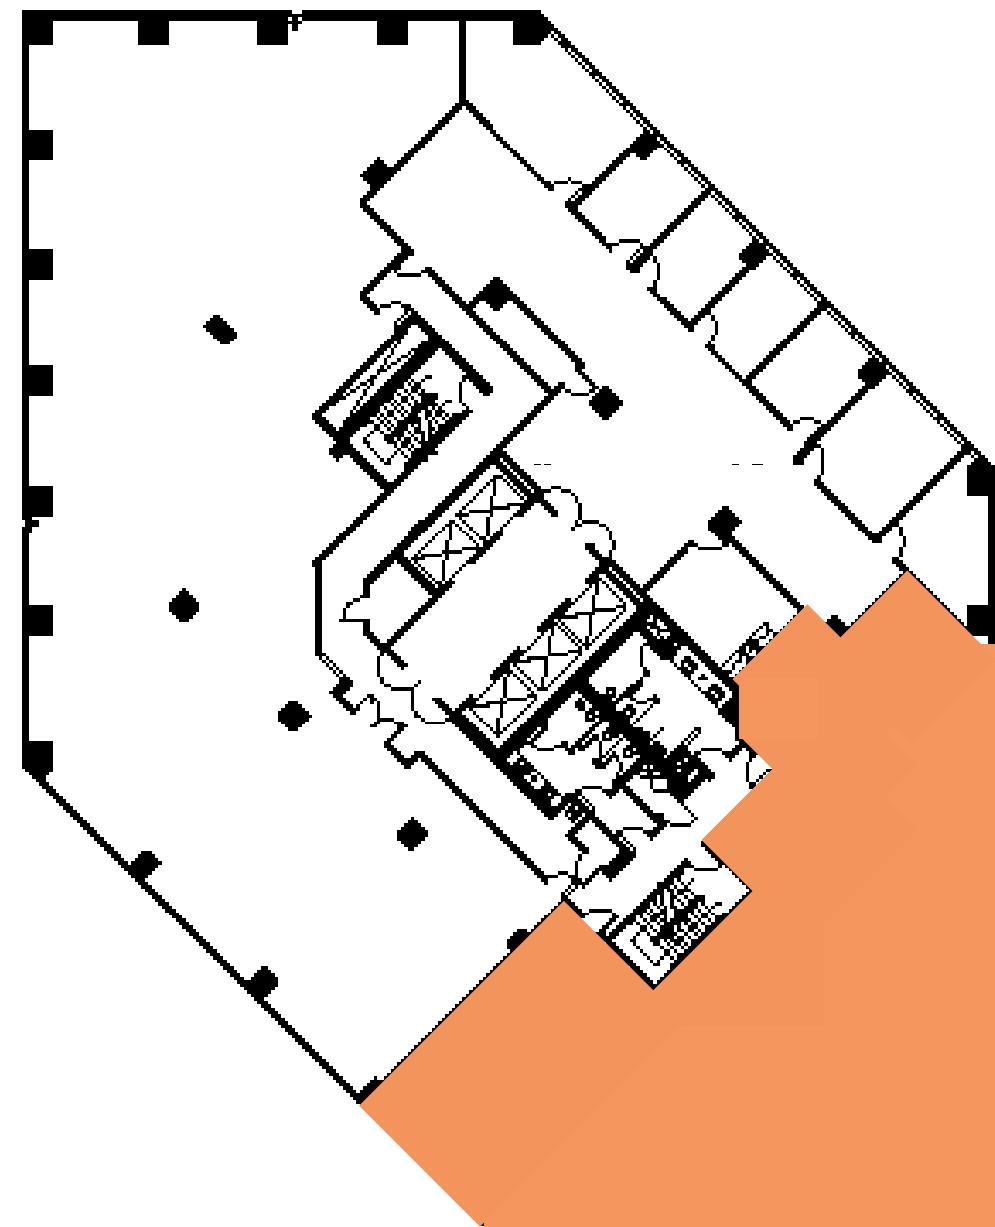

PLEASE CONTACT:
USALEASING@ONNI.COM
(213) 629 - 2041