SUITE: 1050

RSF: 6,024

OCEAN PLAZA

AS-BUILT CONFIGURATION

OFFICES	TBD
RECEPTION	TBD
CONFERENCE ROOMS	TBD
KITCHEN	TBD
OPEN WORK AREA	TBD

Not to scale, furniture and appliances not included

KEY PLAN

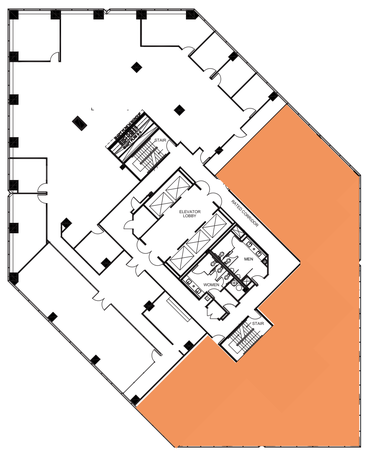

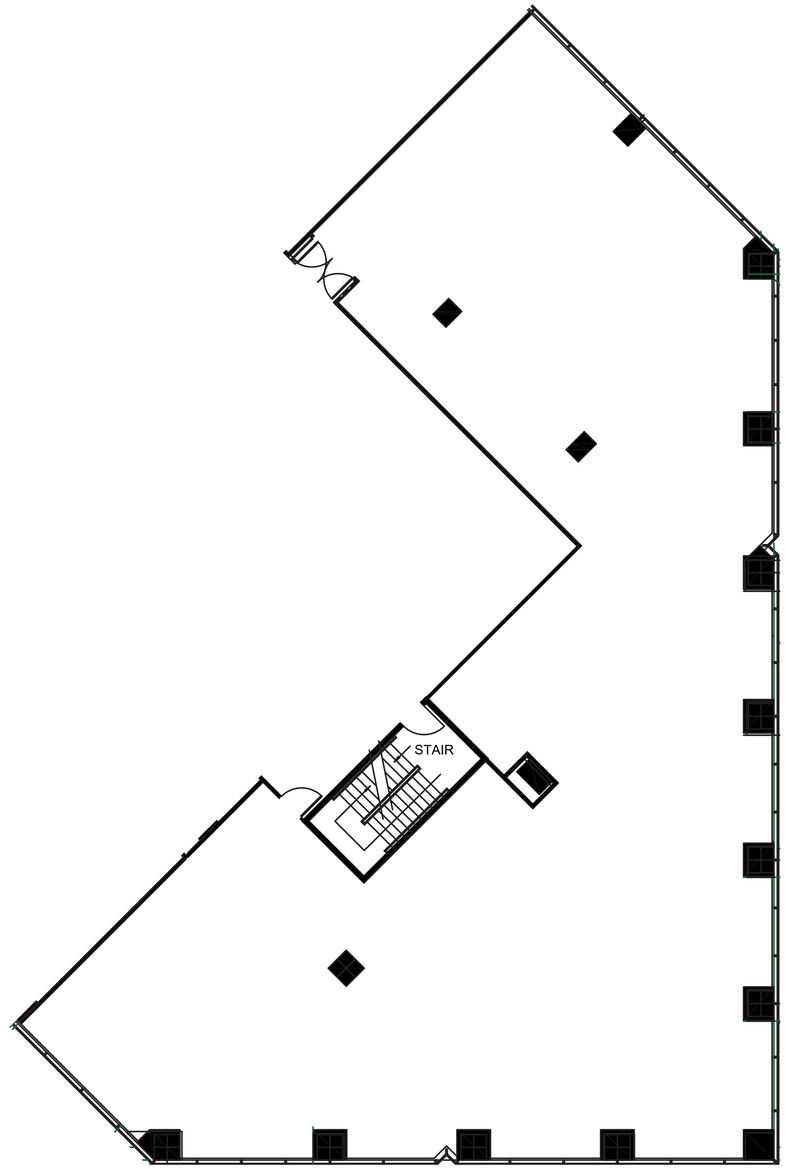

PLEASE CONTACT:
USALEASING@ONNI.COM
(213) 629 - 2041

onni group