SUITE: 1130 RSF: 2,142

POINT BREAK TOWER
AT OCEAN PLAZA

AS-BUILT CONFIGURATION

PRIVATE OFFICES.....1

CONFERENCE ROOMS.....1

KITCHEN.....1

RECEPTION.....1

OPEN WORK AREA.....+/-6

Not to scale, furniture and appliances not included

KEY PLAN

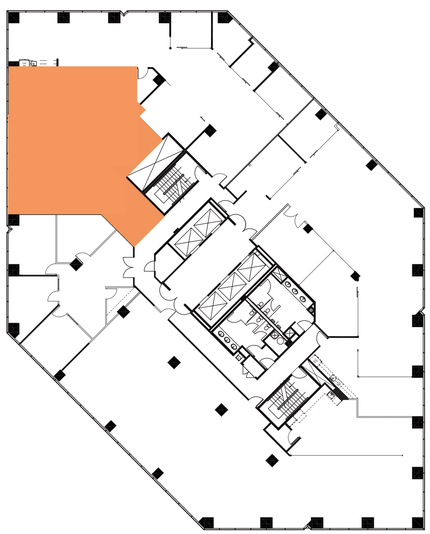

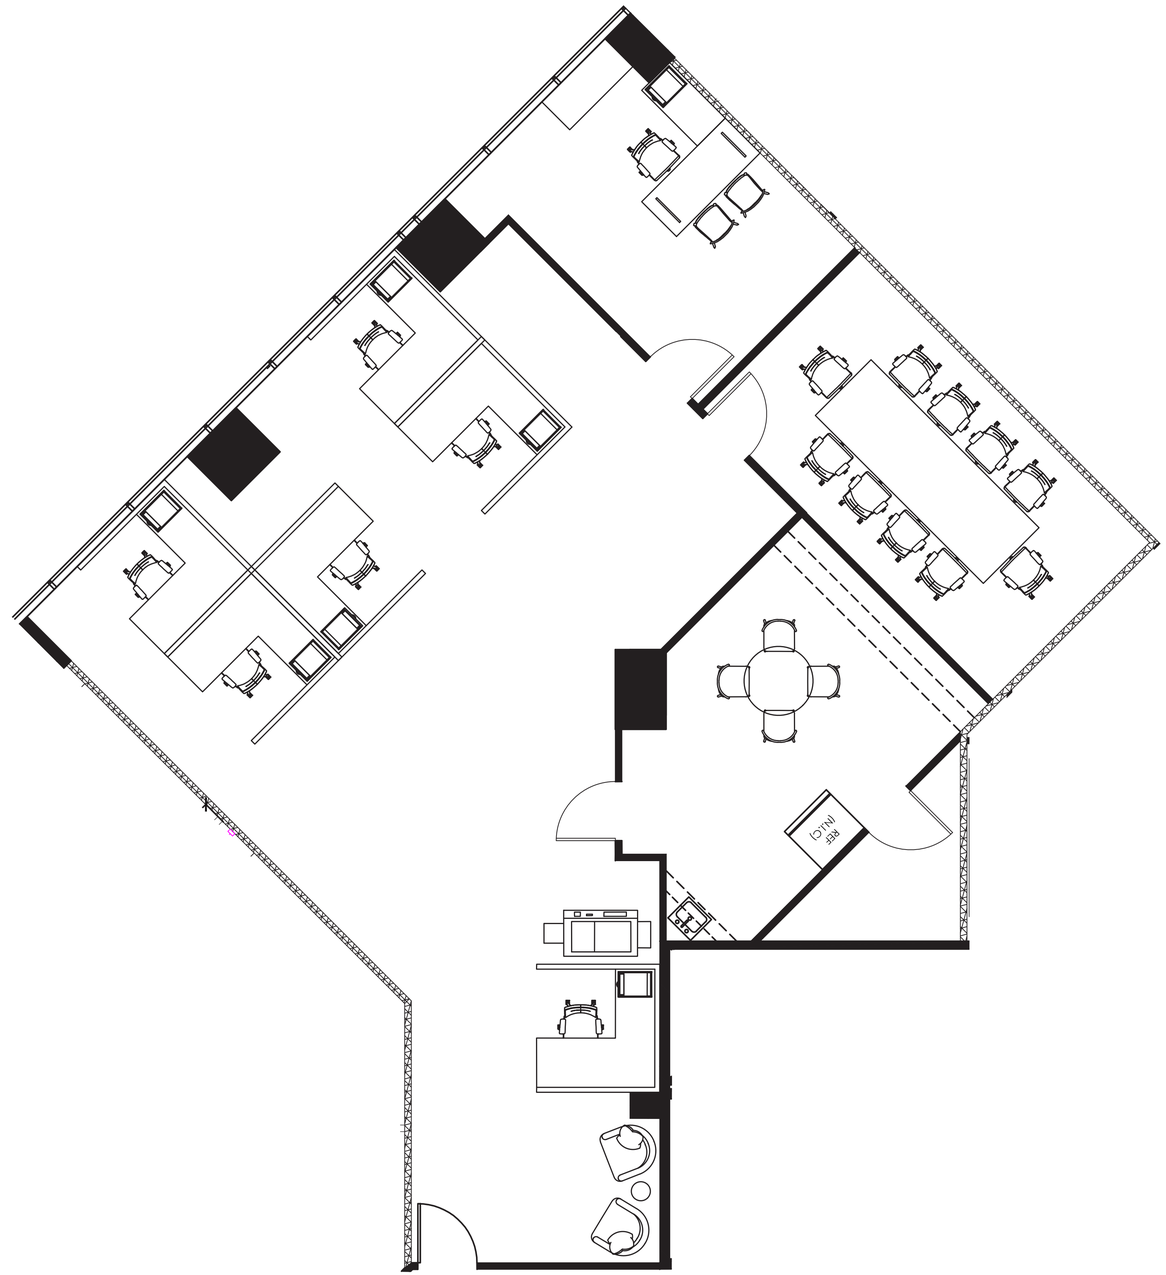

PLEASE CONTACT:
USALEASING@ONNI.COM
(213) 629 - 2041

onni group®