SUITE: 1240 RSF: 4,117

OCEAN PLAZA

AS-BUILT CONFIGURATION

OFFICES..... 6

RECEPTION..... 1

CONFERENCE ROOMS..... 1

KITCHEN..... 1

OPEN WORK AREA..... 0

Not to scale, furniture and appliances not included

KEY PLAN

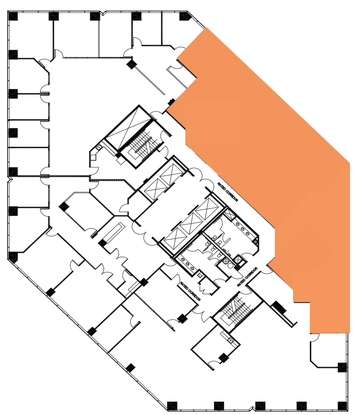

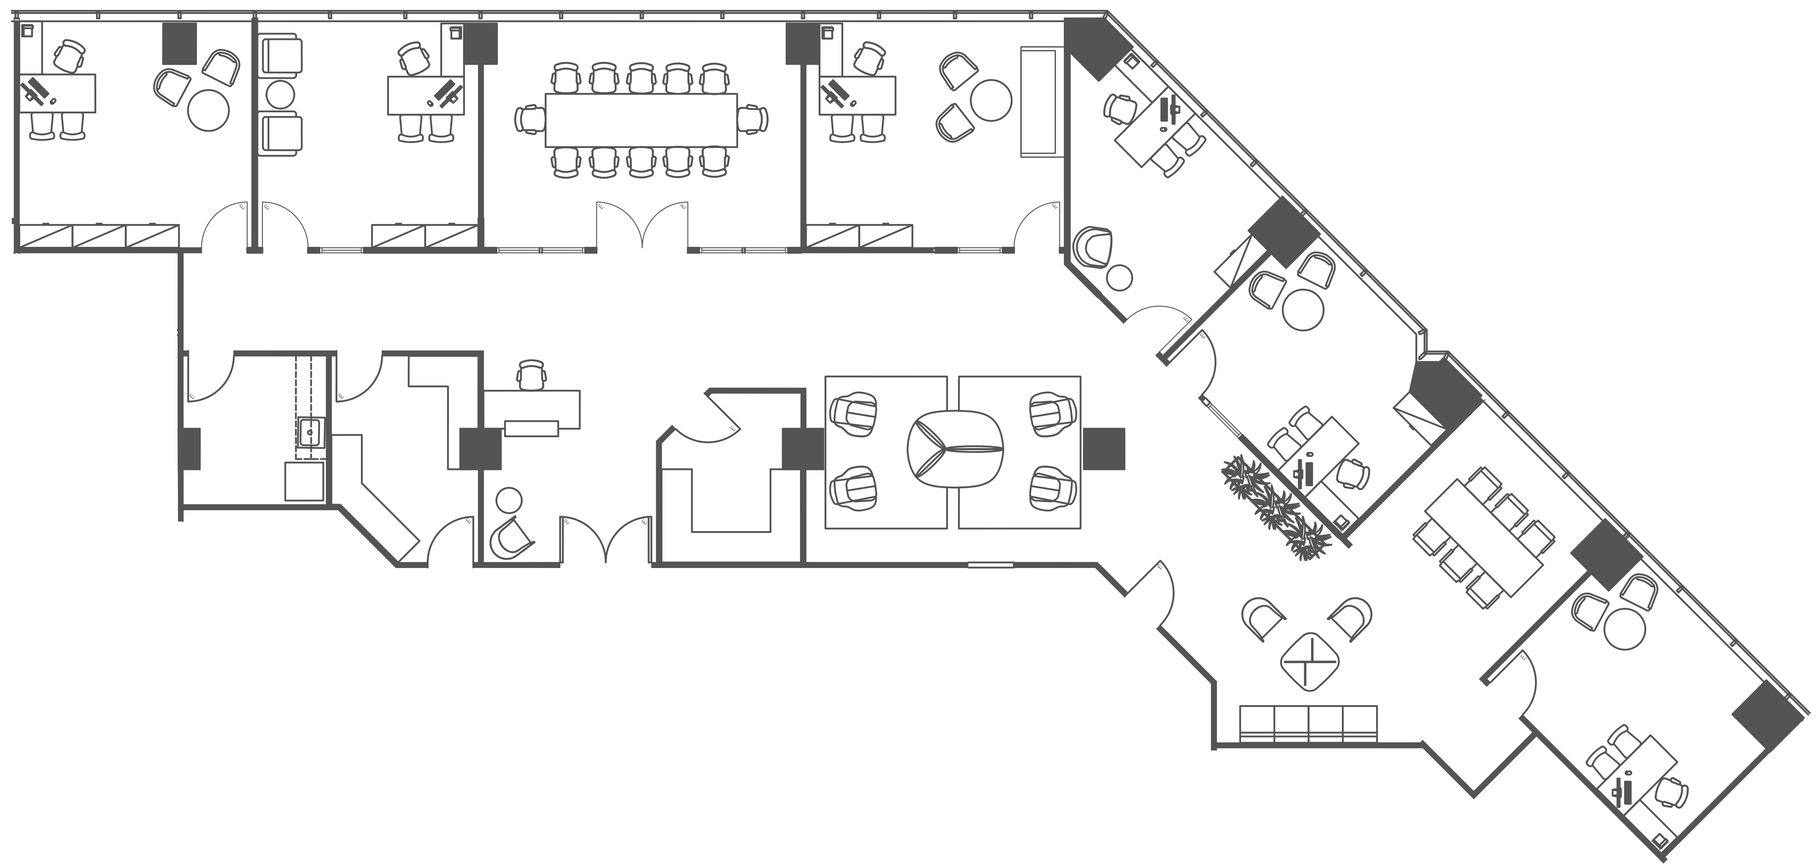

For leasing information please contact:
Jason Ward
949.955.7640 | jason.ward@cushwake.com

Adie Jessup
949.930.9258 | adie.jessup@cushwake.com

John Harty
949.372.4910 | john.harty@cushwake.com

onni group®