SUITE: 510 RSF: 1,820

POINT BREAK TOWER
AT OCEAN PLAZA

AS-BUILT CONFIGURATION

CONFERENCE ROOMS.....1

PRIVATE OFFICES.....1

KITCHEN.....1

OPEN WORK AREA.....+/-11

Not to scale, furniture and appliances not included

KEY PLAN

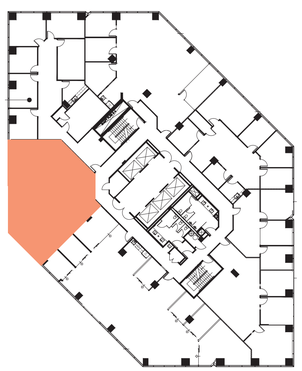

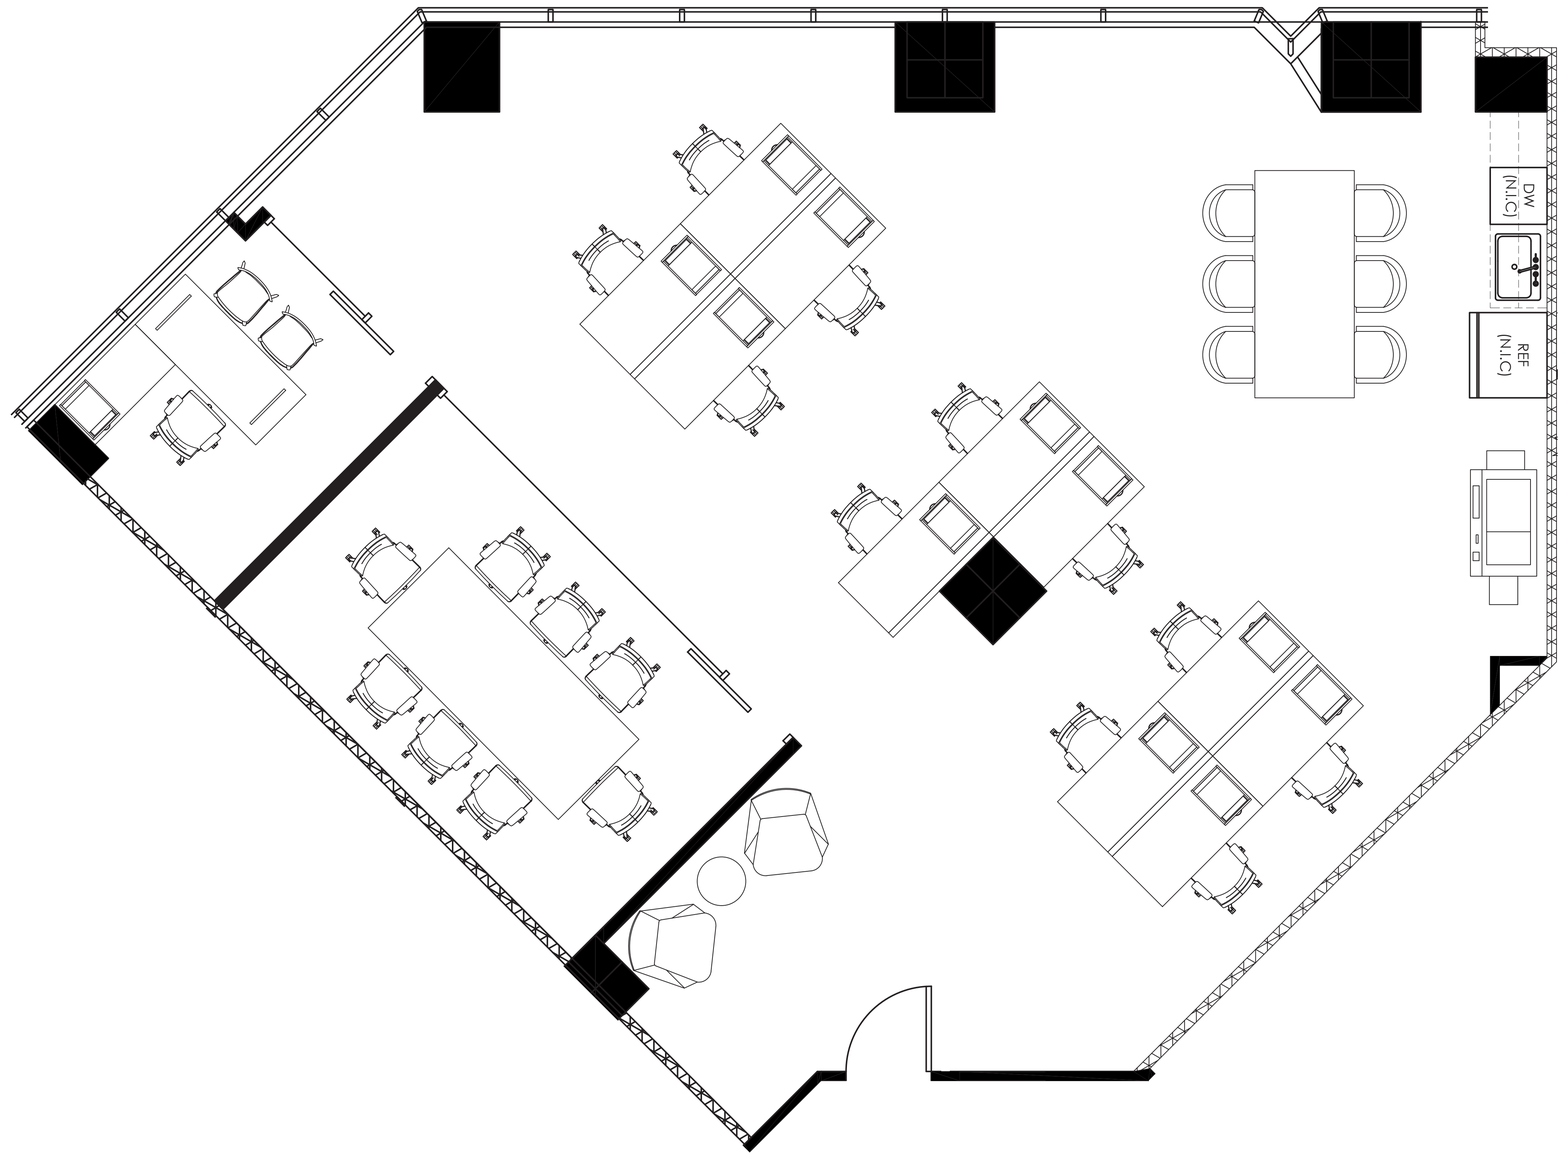

PLEASE CONTACT:
USALEASING@ONNI.COM

onni group®