SUITE: 750 RSF: 1,959

POINT BREAK TOWER
AT OCEAN PLAZA

AS-BUILT CONFIGURATION

PRIVATE OFFICES..... 1

RECEPTION..... 1

CONFERENCE ROOMS..... 1

KITCHEN..... 1

OPEN WORK AREA..... +/- 16

Not to scale, furniture and appliances not included

KEY PLAN

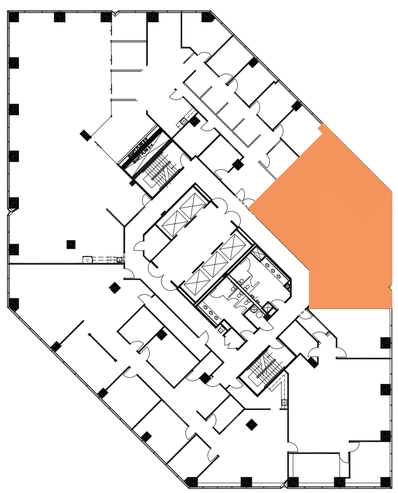

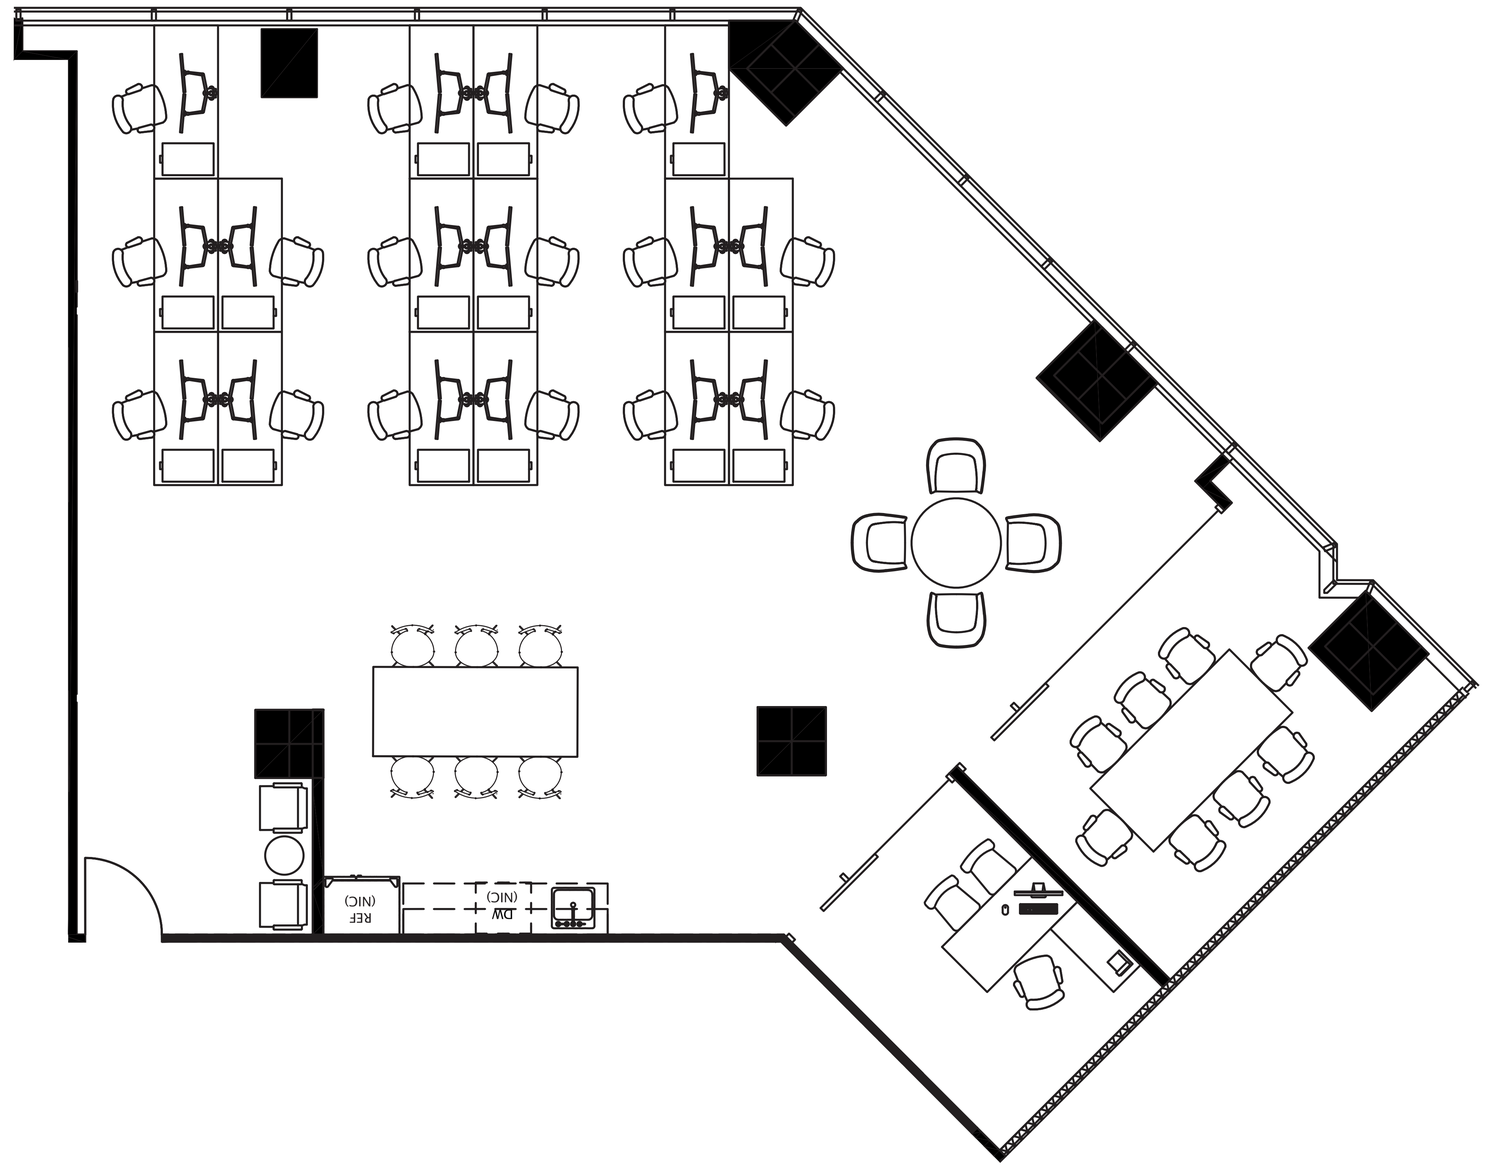

onni group